

# Work Order ID 81190

**\*81190\***

Page 1

March-12-12 8:41:59 AM

Item ID: D3916-5

Accept

**\*N900040100\***

Setup Start **\*NS1\***

Revision ID:

Item Name: Light Rib

Stop **\*NS2\***

Start Date: 09/03/2012 Start Qty: 2.00

**\*2\***

Cust Item ID:

Required Date: 19/03/2012 Req'd Qty: 2.00

**\*2\***

Customer:

Reference:

Approvals: Process Plan: MLJ

Date: 12/03/12 Tooling:

Date:

Run Start **\*NR1\***

QC:

Date: SPC (Y/N):

Date:

Stop **\*NR2\***

Sequence ID/ Work Center ID	Operation Description	Set Up/ Run Hours	Tool ID	Tool #	Plan Code	Accept Qty	Reject Qty	Reject Number	Insp. Stamp
--------------------------------	--------------------------	----------------------	---------	--------	--------------	---------------	---------------	------------------	----------------

Draw Nbr

Revision Nbr

D3916

A

100

0.00

**\*100\***

Large Fab

Memo

0.00

Large Fab

1- Cut tube 50"  
2- Bend tube with manuel pipe bender as per DT9566  
\*\*\* Make line at 9.00" annd use jig for other line\*\*\*  
3- Trim access tube material to finish size as per dwg D3916

12 SAD 12-04-11

110

QC6- Inspect dimensions to drawing

0.00

**\*110\***

QC

Memo

0.00

Quality Control

12.04.11 (12)

120

Identify as per dwg & Stock Location:

0.00

**\*120\***

Packaging

Memo

0.00

Packaging

12.04.11 (12)

W/O:		WORK ORDER CHANGES					
DATE	STEP	PROCEDURE CHANGE	By	Date	Qty	Approval Chief Eng / Prod Mgr	Approval QC Inspector

Part No: \_\_\_\_\_ PAR #: \_\_\_\_\_ Fault Category: \_\_\_\_\_ NCR: Yes No DQA: \_\_\_\_\_ Date: \_\_\_\_\_

Resolution: \_\_\_\_\_ Disposition: \_\_\_\_\_ QA: N/C Closed: \_\_\_\_\_ Date: \_\_\_\_\_

NCR:		WORK ORDER NON-CONFORMANCE (NCR)						
DATE	STEP	Description of NC Section A	Corrective Action Section B			Verification Section C	Approval Chief Eng	Approval QC Inspector
			Initial Chief Eng	Action Description Chief Eng	Sign & Date			

**NOTE:** Date & initial all entries

**Work Order ID 81190**

March-12-12 8:41:59 AM

**\*81190\***

Page 2

Item ID: D3916-5

Accept

**\*N900040100\***Setup Start **\*NS1\***

Revision ID:

Item Name: Light Rib

Stop **\*NS2\***

Start Date: 09/03/2012 Start Qty: 2.00

**\*2\***

Cust Item ID:

Required Date: 19/03/2012 Req'd Qty: 2.00

**\*2\***

Customer:

Reference:

Approvals:

Process Plan:

Date:

Tooling:

Date:

Run Start **\*NR1\***

QC:

Date:

SPC (Y/N):

Date:

Stop **\*NR2\***Sequence ID/  
Work Center IDOperation  
DescriptionSet Up/  
Run Hours

Tool ID

Tool #

Plan  
CodeAccept  
QtyReject  
QtyReject  
NumberInsp.  
Stamp

130

QC21- Final Inspection - Work Order Release

0.00

**\*130\***

QC

Memo

0.00

Quality Control

12/4/12  
ME  
12-04-11

W/O:		WORK ORDER CHANGES					
DATE	STEP	PROCEDURE CHANGE	By	Date	Qty	Approval Chief Eng / Prod Mgr	Approval QC Inspector

Part No: \_\_\_\_\_ PAR #: \_\_\_\_\_ Fault Category: \_\_\_\_\_ NCR: Yes No DQA: \_\_\_\_\_ Date: \_\_\_\_\_

Resolution: \_\_\_\_\_ Disposition: \_\_\_\_\_ QA: N/C Closed: \_\_\_\_\_ Date: \_\_\_\_\_

NCR:		WORK ORDER NON-CONFORMANCE (NCR)						
DATE	STEP	Description of NC Section A	Corrective Action Section B			Verification Section C	Approval Chief Eng	Approval QC Inspector
			Initial Chief Eng	Action Description Chief Eng	Sign & Date			

**NOTE:** Date & initial all entries

# Picklist Print

March-12-12 8:42:03 AM

Page 1

Work Order ID: 81190

\*81190\*

Parent Item: D3916-5

\*D3916-5\*

Parent Item Name: Light Rib

Start Date: 09/03/2012

Required Date: 19/03/2012

Start Qty: 2.00

Required Qty: 2.00

Comments: IPP RevA: new issue DD 09.11.23 verified by:EC  
as per dwg revA 10.03.15 verified by:EC

IPP Rev:B

Component Item ID/ Item Name	Replacement Item ID	Mfg/ Purch	Bin Item	Primary Location	Last Location	Route Seq ID	Unit of Measure	Qty on Hand	Qty per Kit	Total Qty	Qty Issued	Date Issued	Status
---------------------------------	------------------------	---------------	-------------	---------------------	------------------	-----------------	--------------------	----------------	-------------	--------------	---------------	----------------	--------

M304TS0.500W.049

Purchased

No

100

f

348.2521

4.166

~~8.770526~~

52.6256

\*M304TS0 500W 049\*

\*\*

SAD

12-04-11

Square Tubing

## Location

## Loc Qty

## Loc Code

MAT034

348.2520653

116610

0.8383

117721

0.3234

117999

2.43919739

118460

344.651168

M121328 52.6236

W/O:		WORK ORDER CHANGES					
DATE	STEP	PROCEDURE CHANGE	By	Date	Qty	Approval Chief Eng / Prod Mgr	Approval QC Inspector


Part No: \_\_\_\_\_ PAR #: \_\_\_\_\_ Fault Category: \_\_\_\_\_ NCR: Yes No DQA: \_\_\_\_\_ Date: \_\_\_\_\_

Resolution: \_\_\_\_\_ Disposition: \_\_\_\_\_ QA: N/C Closed: \_\_\_\_\_ Date: \_\_\_\_\_


NCR:		WORK ORDER NON-CONFORMANCE (NCR)						
DATE	STEP	Description of NC Section A	Corrective Action Section B			Verification Section C	Approval Chief Eng	Approval QC Inspector
			Initial Chief Eng	Action Description Chief Eng	Sign & Date			

**NOTE:** Date & initial all entries

ITEM	QTY	P/N	DESCRIPTION
	X	D3916-041	RIB ASSY
1	1	D3916-1	RIB
2	7	D3759-1	BUSHING

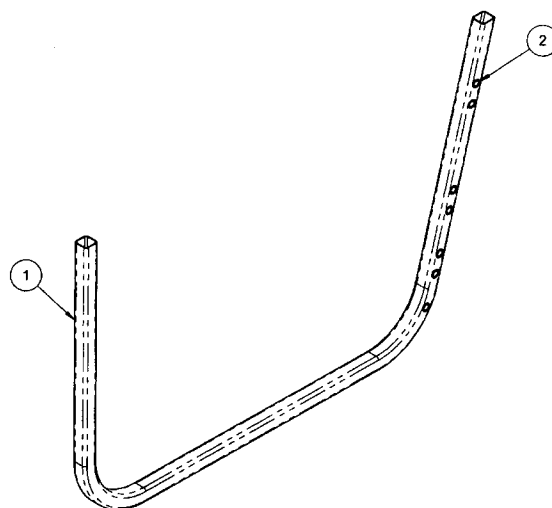

**D3916-041 RIB ASSY**

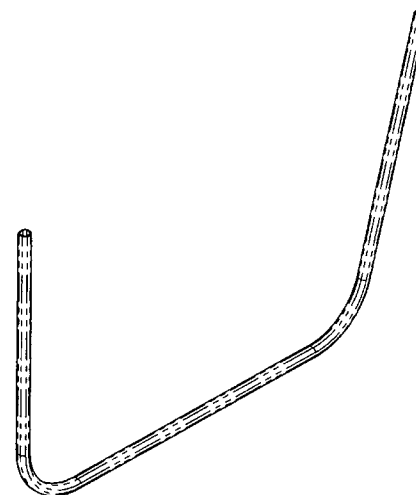

**D3916-5 LIGHT RIB**

SHOP COPY  
RETURN TO  
ENGINEERING  
UNCONTROLLED COPY  
SUBJECT TO AMENDMENT  
WITHOUT NOTICE  
WORK ORDER

NO. 81190415  
12103112

OL 10.12.21  
~~UNDER REVIEW~~

ADDITION OF HOLE + BUSHING  
ON D3916-041-1 RIBS.

**RELEASED**  
2010-03-12

A	NEW ISSUE	JPH	10.03.04
REV.	DESCRIPTION	BY	DATE
DESIGN	AJS	<b>DART AEROSPACE LTD</b> HAWKESBURY, ONTARIO, CANADA	
DRAWN	JPH		
CHECKED	<i>[Signature]</i>	DRAWING NO.	REV. A
MFG. APPR.	<i>[Signature]</i>	D3916	SHEET 1 OF 4
APPROVED	<i>[Signature]</i>	TITLE	SCALE
DE APPR.	<i>[Signature]</i>	RIB ASSY, 350 BASKET	NTS
DATE	10.03.04	COPYRIGHT © 2010 BY DART AEROSPACE LTD <small>THIS DOCUMENT IS PRIVATE AND CONFIDENTIAL AND IS SUPPLIED ON THE EXPRESS CONDITION THAT IT IS NOT TO BE USED FOR ANY PURPOSES OR COMMUNICATED TO ANY OTHER PERSON WITHOUT WRITTEN PERMISSION FROM DART AEROSPACE LTD.</small>	

W/O:		WORK ORDER CHANGES					
DATE	STEP	PROCEDURE CHANGE	By	Date	Qty	Approval Chief Eng / Prod Mgr	Approval QC Inspector

Part No: \_\_\_\_\_ PAR #: \_\_\_\_\_ Fault Category: \_\_\_\_\_ NCR: Yes No DQA: \_\_\_\_\_ Date: \_\_\_\_\_


Resolution: \_\_\_\_\_ Disposition: \_\_\_\_\_ QA: N/C Closed: \_\_\_\_\_ Date: \_\_\_\_\_

NCR:		WORK ORDER NON-CONFORMANCE (NCR)						
DATE	STEP	Description of NC Section A	Corrective Action Section B			Verification Section C	Approval Chief Eng	Approval QC Inspector
			Initial Chief Eng	Action Description Chief Eng	Sign & Date			

**NOTE:** Date & initial all entries



81190

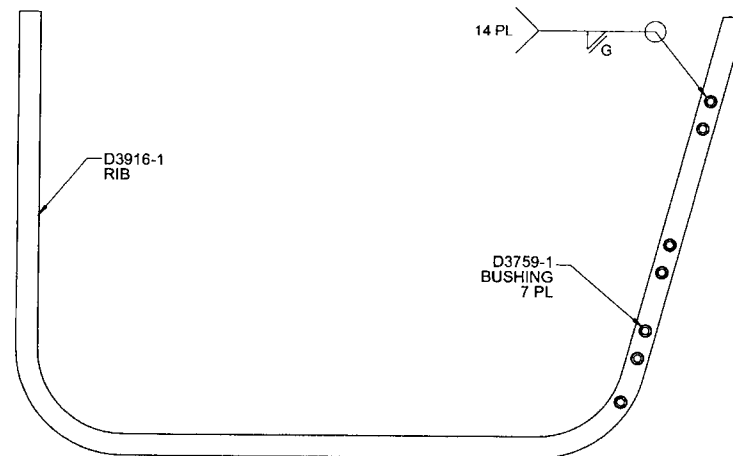

**D3916-041 RIB ASSY**

**RELEASED**  
2010-03-12  
AMP

**NOTES:**

- 1) MATERIAL: N/A
- 2) FINISH: NONE
- 3) TOLERANCES: PER DART QSI 018 UNLESS OTHERWISE NOTED
- 4) UNITS: INCHES UNLESS OTHERWISE NOTED
- 5) BREAK SHARP EDGES: N/A
- 6) IDENTIFICATION: NONE
- 7) WEIGHT -041: 1.84 lbs
- 8) WELD PER DART QSI 004

DESIGN	AJS	<b>DART AEROSPACE LTD</b>	
DRAWN	JPH	HAWKESBURY, ONTARIO, CANADA	
CHECKED	g	DRAWING NO.	REV. A
MFG. APPR.	E	D3916	SHEET 2 OF 4
APPROVED	AMP	TITLE	SCALE
DE APPR.	#	RIB ASSY, 350 BASKET	NTS
DATE	10.03.04	<small>COPYRIGHT © 2010 BY DART AEROSPACE LTD THIS DOCUMENT IS PRIVATE AND CONFIDENTIAL AND IS SUPPLIED ON THE EXPRESS UNDERSTANDING THAT IT IS NOT TO BE USED FOR ANY PURPOSE, OR COPIED OR COMMUNICATED TO ANY OTHER PERSON WITHOUT WRITTEN PERMISSION FROM DART AEROSPACE LTD</small>	

W/O:		WORK ORDER CHANGES					
DATE	STEP	PROCEDURE CHANGE	By	Date	Qty	Approval Chief Eng / Prod Mgr	Approval QC Inspector



Part No: \_\_\_\_\_ PAR #: \_\_\_\_\_ Fault Category: \_\_\_\_\_ NCR: Yes No DQA: \_\_\_\_\_ Date: \_\_\_\_\_

Resolution: \_\_\_\_\_ Disposition: \_\_\_\_\_ QA: N/C Closed: \_\_\_\_\_ Date: \_\_\_\_\_

NCR:		WORK ORDER NON-CONFORMANCE (NCR)						
DATE	STEP	Description of NC Section A	Corrective Action Section B			Verification Section C	Approval Chief Eng	Approval QC Inspector
			Initial Chief Eng	Action Description Chief Eng	Sign & Date			

**NOTE:** Date & initial all entries

81190

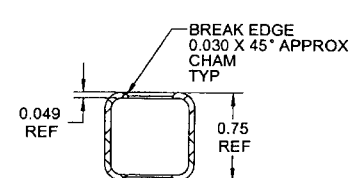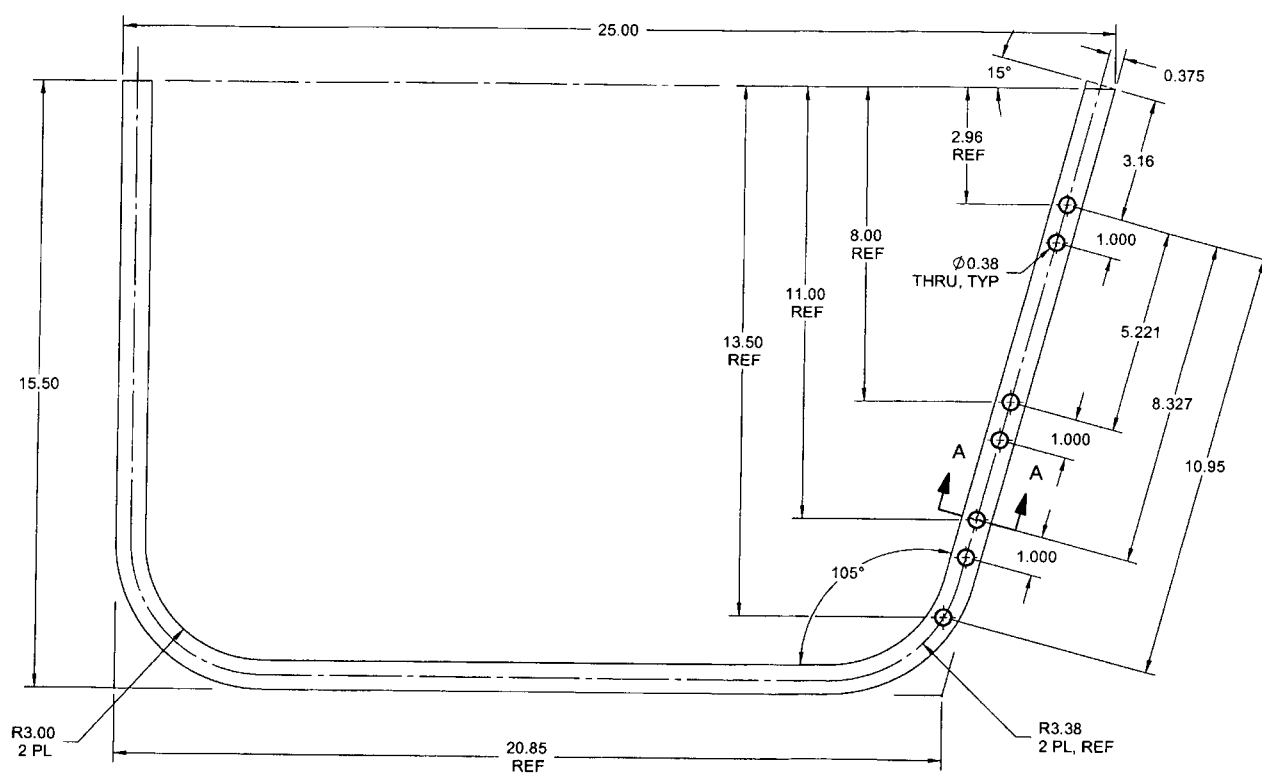

SECTION A-A

9 D3916-1 RIB

RELEASED  
2010-03-12  
NHP

- NOTES:
- 1) MATERIAL: AISI 304/316 STAINLESS STEEL SQUARE TUBE, 0.75 X 0.75 X 0.049 WALL  
REF DART SPEC. M304TS0.750W.049
  - 2) FINISH: NONE
  - 3) TOLERANCES: PER DART QSI 018 UNLESS OTHERWISE NOTED
  - 4) UNITS: INCHES UNLESS OTHERWISE NOTED
  - 5) BREAK SHARP EDGES: 0.005 TO 0.010 MAX
  - 6) IDENTIFICATION: N/A
  - 7) WEIGHT: 1.76 lbs
  - 9) TUBE FLAT LENGTH 50.0 REF

DESIGN	AJS	<b>DART AEROSPACE LTD</b>	
DRAWN	JPH	HAWKESBURY, ONTARIO, CANADA	
CHECKED	<i>[Signature]</i>	DRAWING NO.	REV. A
MFG. APPR.	<i>[Signature]</i>	<b>D3916</b>	SHEET 3 OF 4
APPROVED	<i>[Signature]</i>	TITLE	SCALE
DE APPR.	<i>[Signature]</i>	<b>RIB ASSY, 350 BASKET</b>	NTS
DATE	10.03.04	<small>COPYRIGHT © 2010 BY DART AEROSPACE LTD THIS DOCUMENT IS PRIVATE AND CONFIDENTIAL, AND IS SUPPLIED ON THE EXPRESS CONDITION THAT IT IS NOT TO BE USED FOR ANY PURPOSE OR COPIED OR COMMUNICATED TO ANY OTHER PERSON WITHOUT WRITTEN PERMISSION FROM DART AEROSPACE LTD</small>	

W/O:		WORK ORDER CHANGES					
DATE	STEP	PROCEDURE CHANGE	By	Date	Qty	Approval Chief Eng / Prod Mgr	Approval QC Inspector


Part No: \_\_\_\_\_ PAR #: \_\_\_\_\_ Fault Category: \_\_\_\_\_ NCR: Yes No DQA: \_\_\_\_\_ Date: \_\_\_\_\_

Resolution: \_\_\_\_\_ Disposition: \_\_\_\_\_ QA: N/C Closed: \_\_\_\_\_ Date: \_\_\_\_\_

NCR:		WORK ORDER NON-CONFORMANCE (NCR)						
DATE	STEP	Description of NC Section A	Corrective Action Section B			Verification Section C	Approval Chief Eng	Approval QC Inspector
			Initial Chief Eng	Action Description Chief Eng	Sign & Date			

**NOTE:** Date & initial all entries

81190

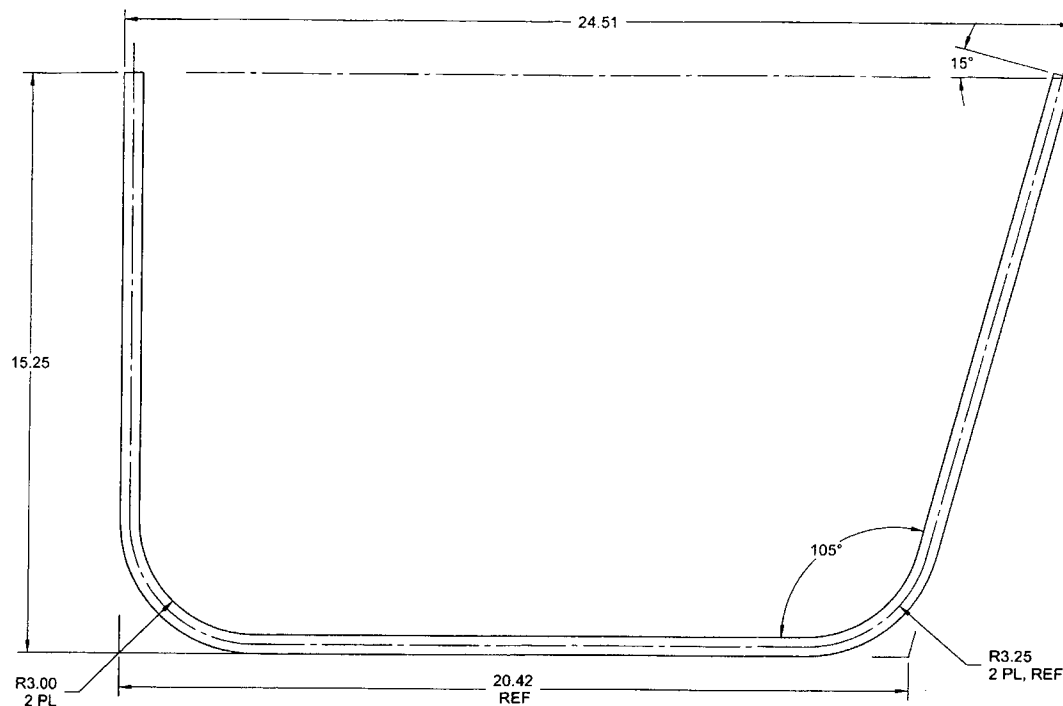

9 D3916-5 LIGHT RIB

**RELEASED**  
2010-03-12  
JPH

**NOTES:**

- 1) MATERIAL: AISI 304/316 STAINLESS STEEL SQUARE TUBE, 0.50 X 0.50 X 0.049 WALL  
REF DART SPEC. M304TS0.500W.049
- 2) FINISH: NONE
- 3) TOLERANCES: PER DART QSI 018 UNLESS OTHERWISE NOTED
- 4) UNITS: INCHES UNLESS OTHERWISE NOTED
- 5) BREAK SHARP EDGES: 0.005 TO 0.010 MAX
- 6) IDENTIFICATION: N/A
- 7) WEIGHT: 1.07 lbs
- 9) TUBE FLAT LENGTH 49.5 REF

DESIGN	AJS	<b>DART AEROSPACE LTD</b>	
DRAWN	JPH	HAWKESBURY, ONTARIO, CANADA	
CHECKED	JPH	DRAWING NO.	REV. A
MFG. APPR.	JPH	D3916	SHEET 4 OF 4
APPROVED	JPH	TITLE	SCALE
DE APPR.	JPH	RIB ASSY, 350 BASKET	NTS
DATE	10.03.04	<small>COPYRIGHT © 2010 BY DART AEROSPACE LTD THIS DOCUMENT IS PRIVATE AND CONFIDENTIAL AND IS SUPPLIED ON THE EXPRESS CONDITION THAT IT IS NOT TO BE USED FOR ANY PURPOSE OR COPIED OR COMMUNICATED TO ANY OTHER PERSON WITHOUT WRITTEN PERMISSION FROM DART AEROSPACE LTD</small>	

W/O:		WORK ORDER CHANGES					
DATE	STEP	PROCEDURE CHANGE	By	Date	Qty	Approval Chief Eng / Prod Mgr	Approval QC Inspector

Part No: \_\_\_\_\_ PAR #: \_\_\_\_\_ Fault Category: \_\_\_\_\_ NCR: Yes No DQA: \_\_\_\_\_ Date: \_\_\_\_\_

Resolution: \_\_\_\_\_ Disposition: \_\_\_\_\_ QA: N/C Closed: \_\_\_\_\_ Date: \_\_\_\_\_

NCR:		WORK ORDER NON-CONFORMANCE (NCR)						
DATE	STEP	Description of NC Section A	Corrective Action Section B			Verification Section C	Approval Chief Eng	Approval QC Inspector
			Initial Chief Eng	Action Description Chief Eng	Sign & Date			

**NOTE:** Date & initial all entries